

A

B

C

D

A

B



C

D

11-11
4x90°=360°

B-208 Valymas.

Ash removal system. Isometric view

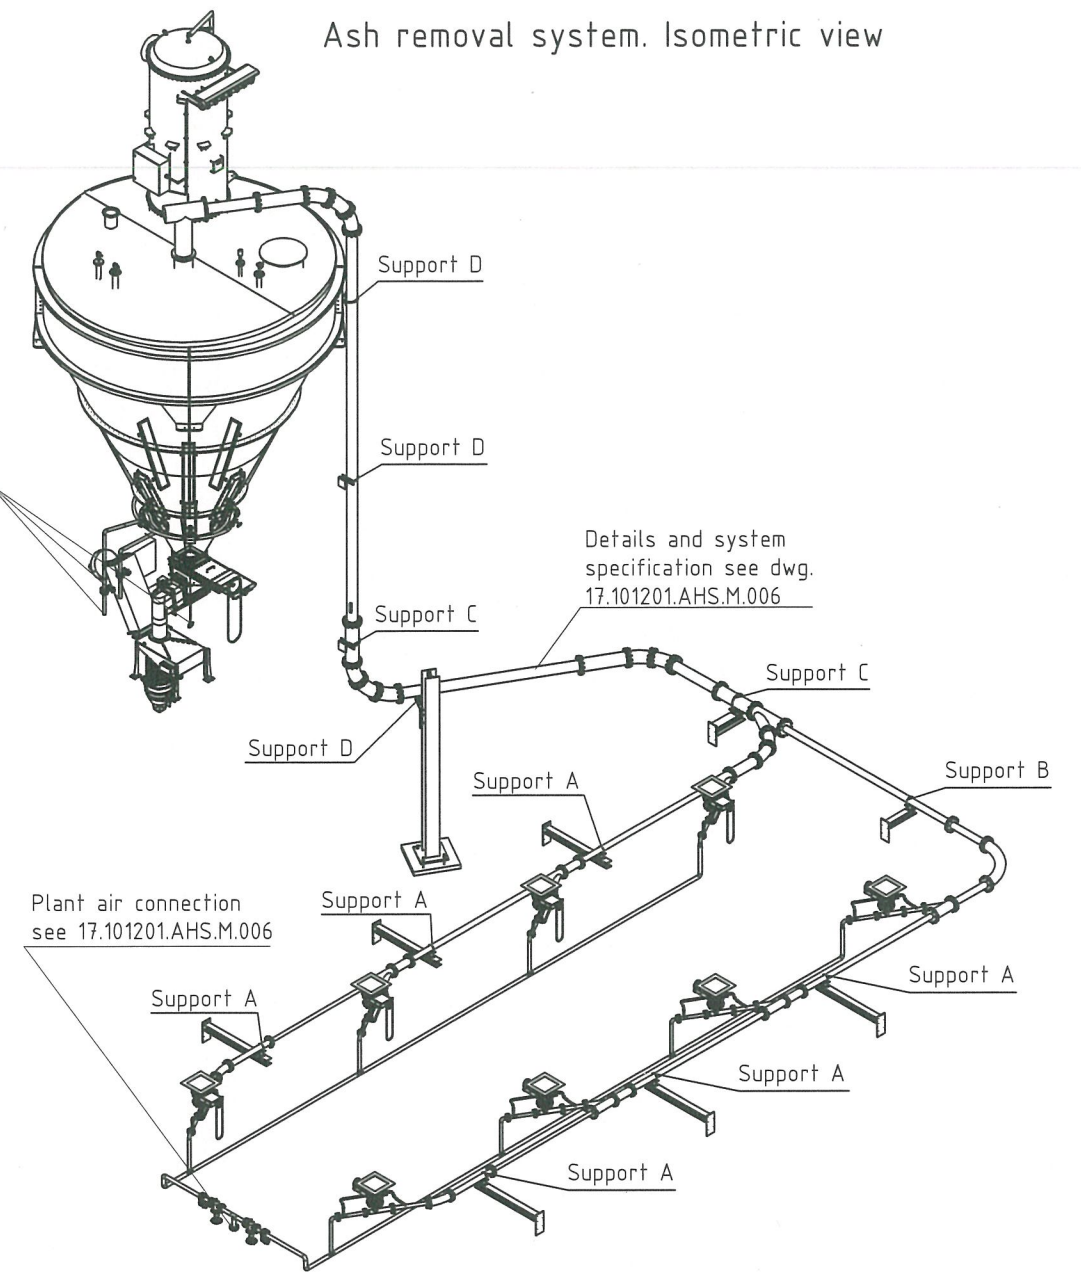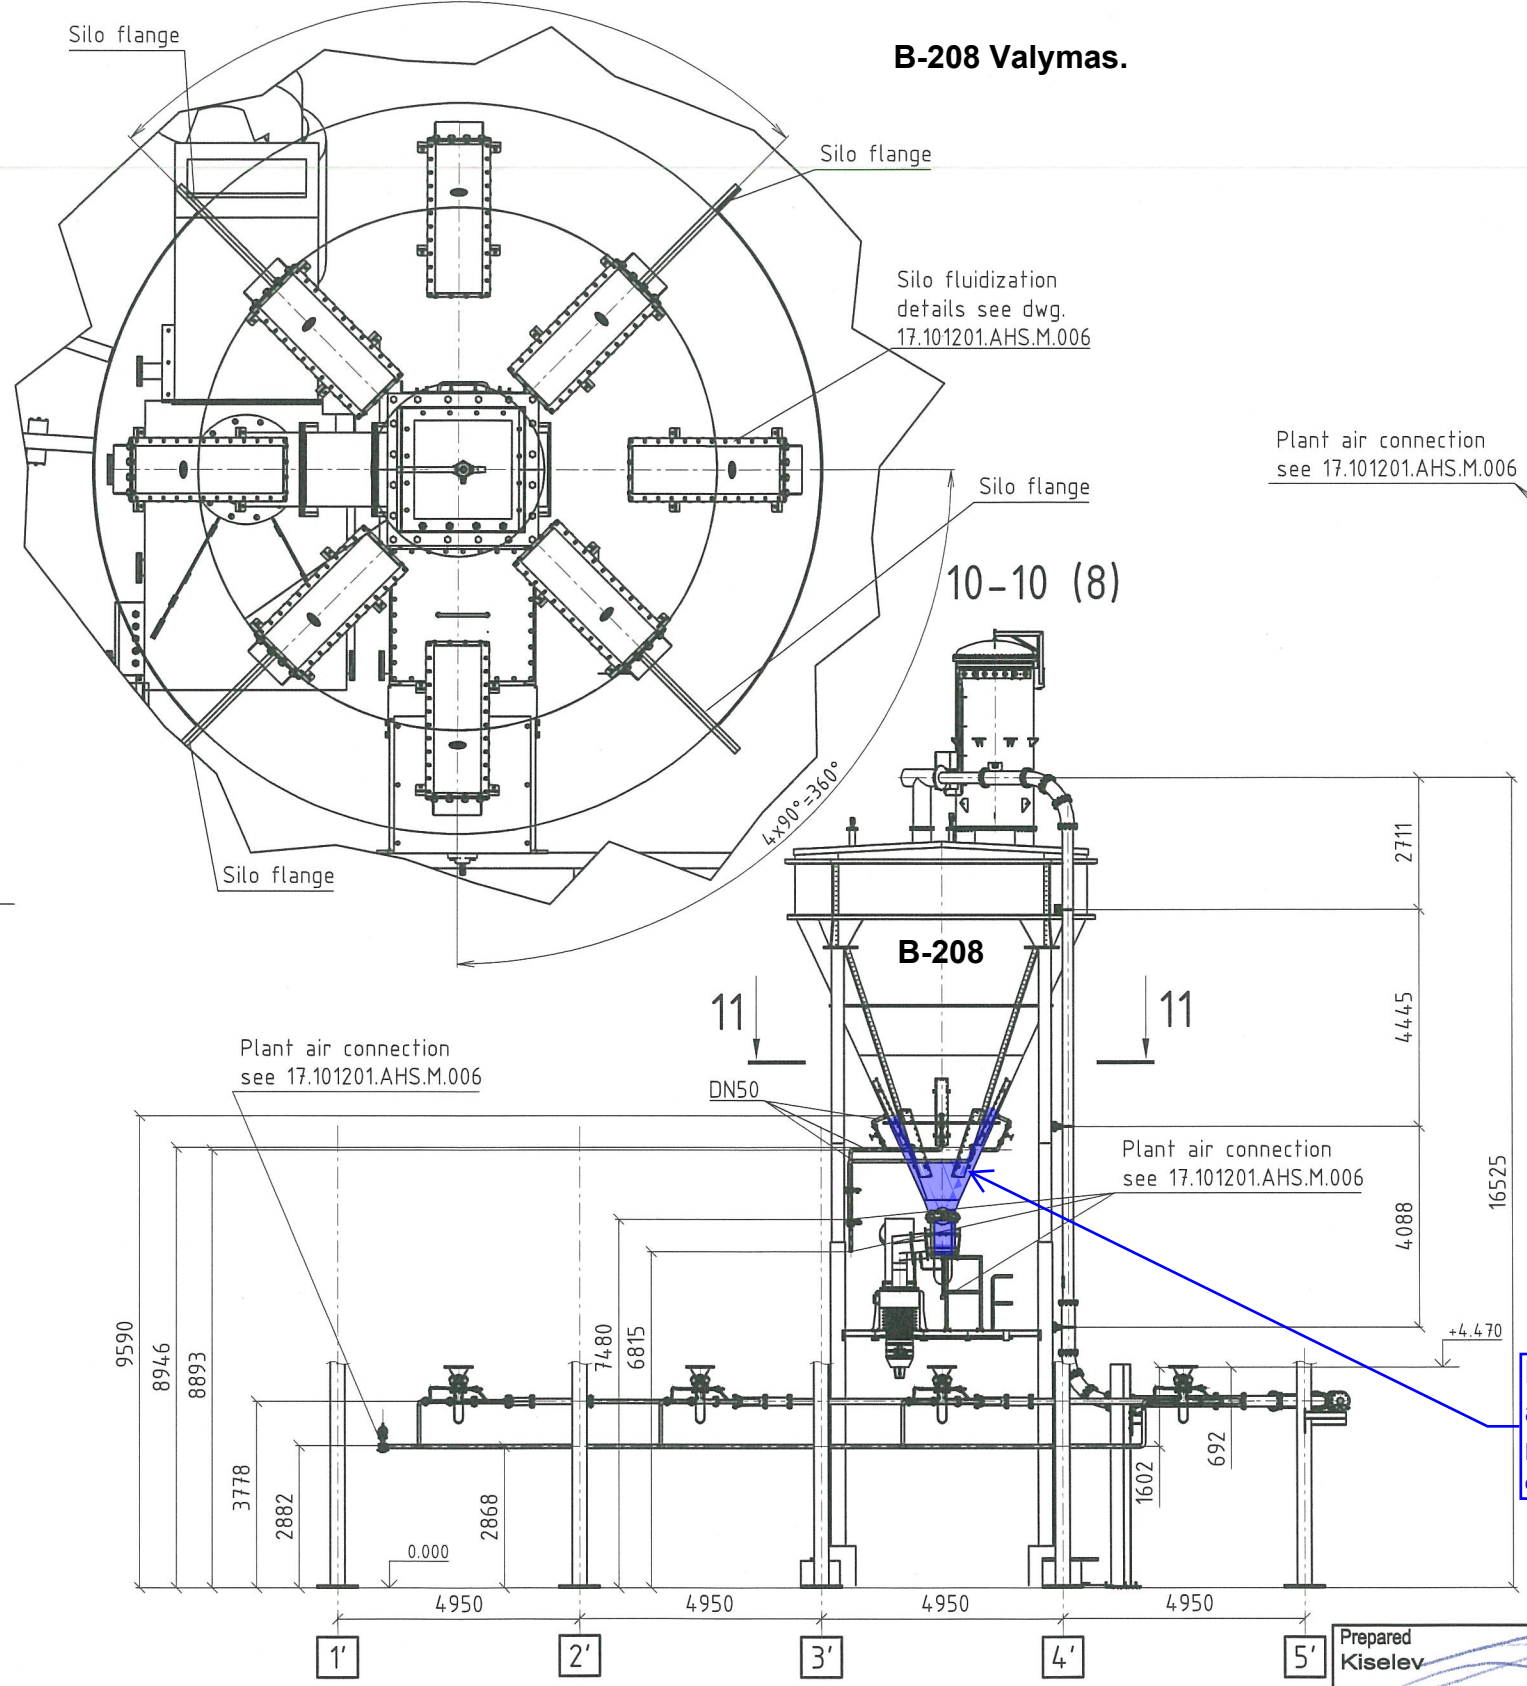

B-208 Išsiurbti vakumo mašina, išvalyti kubo apatinę dalį 1 vnt. nuo katalizatoriaus likučių 5 m³. /B-208 Vacuum out, clean the lower part of the cube 1 pcs. from catalyst residues 5 m³

© COPYRIGHT 2015 General Electric Company (USA)
All rights reserved. The information herein is Proprietary and Technically Exclusive content that is solely owned by General Electric Company and/or its affiliates. Thus, it is being provided with the explicit expectation of restricted and privileged use. All persons or legal entities receiving this information shall be deemed by the act of its receipt to have contractually agreed to make no duplications, reproductions or any nature by any means, modifications, disclosures, or use any portion of this material, except as is expressly authorized in writing by General Electric Company and/or its legitimate affiliates.

| | | | | | |
|-----|------------|----------|----------|----------|------------------|
| H | 2019-04-16 | Kiselev | Maslikov | Dushin | as built |
| G | 2019-01-23 | Kiselev | Maslikov | Dushin | as built |
| F | 2018-03-26 | Kiselev | Maslikov | Dushin | for construction |
| E | 2018-03-05 | Kiselev | Maslikov | Dushin | for construction |
| D | 2017-12-07 | Kiselev | Nokhrin | Dushin | for construction |
| Rev | Date | Drawn by | Checked | Approved | Reason for issue |

| | | | |
|---------------------|---|--|----------------------------|
| Prepared Kiselev | Resp.department Date 2019-04-16 | Title General Arrangement drawing with Battery Limits | Tot.Weight |
| Checked Maslikov | Project Name 430-10 FCC ORLEN Lietuva | Scale 1:150 | Language ENG |
| Approved Dushin | Project No. OLP00964 / C-1014 | GP-2 FCC Dust removal by ESP Technology | |
| GE Power | | Drawing No. 17.101400.TX.002 | Sheet 9(10) Rev H |