


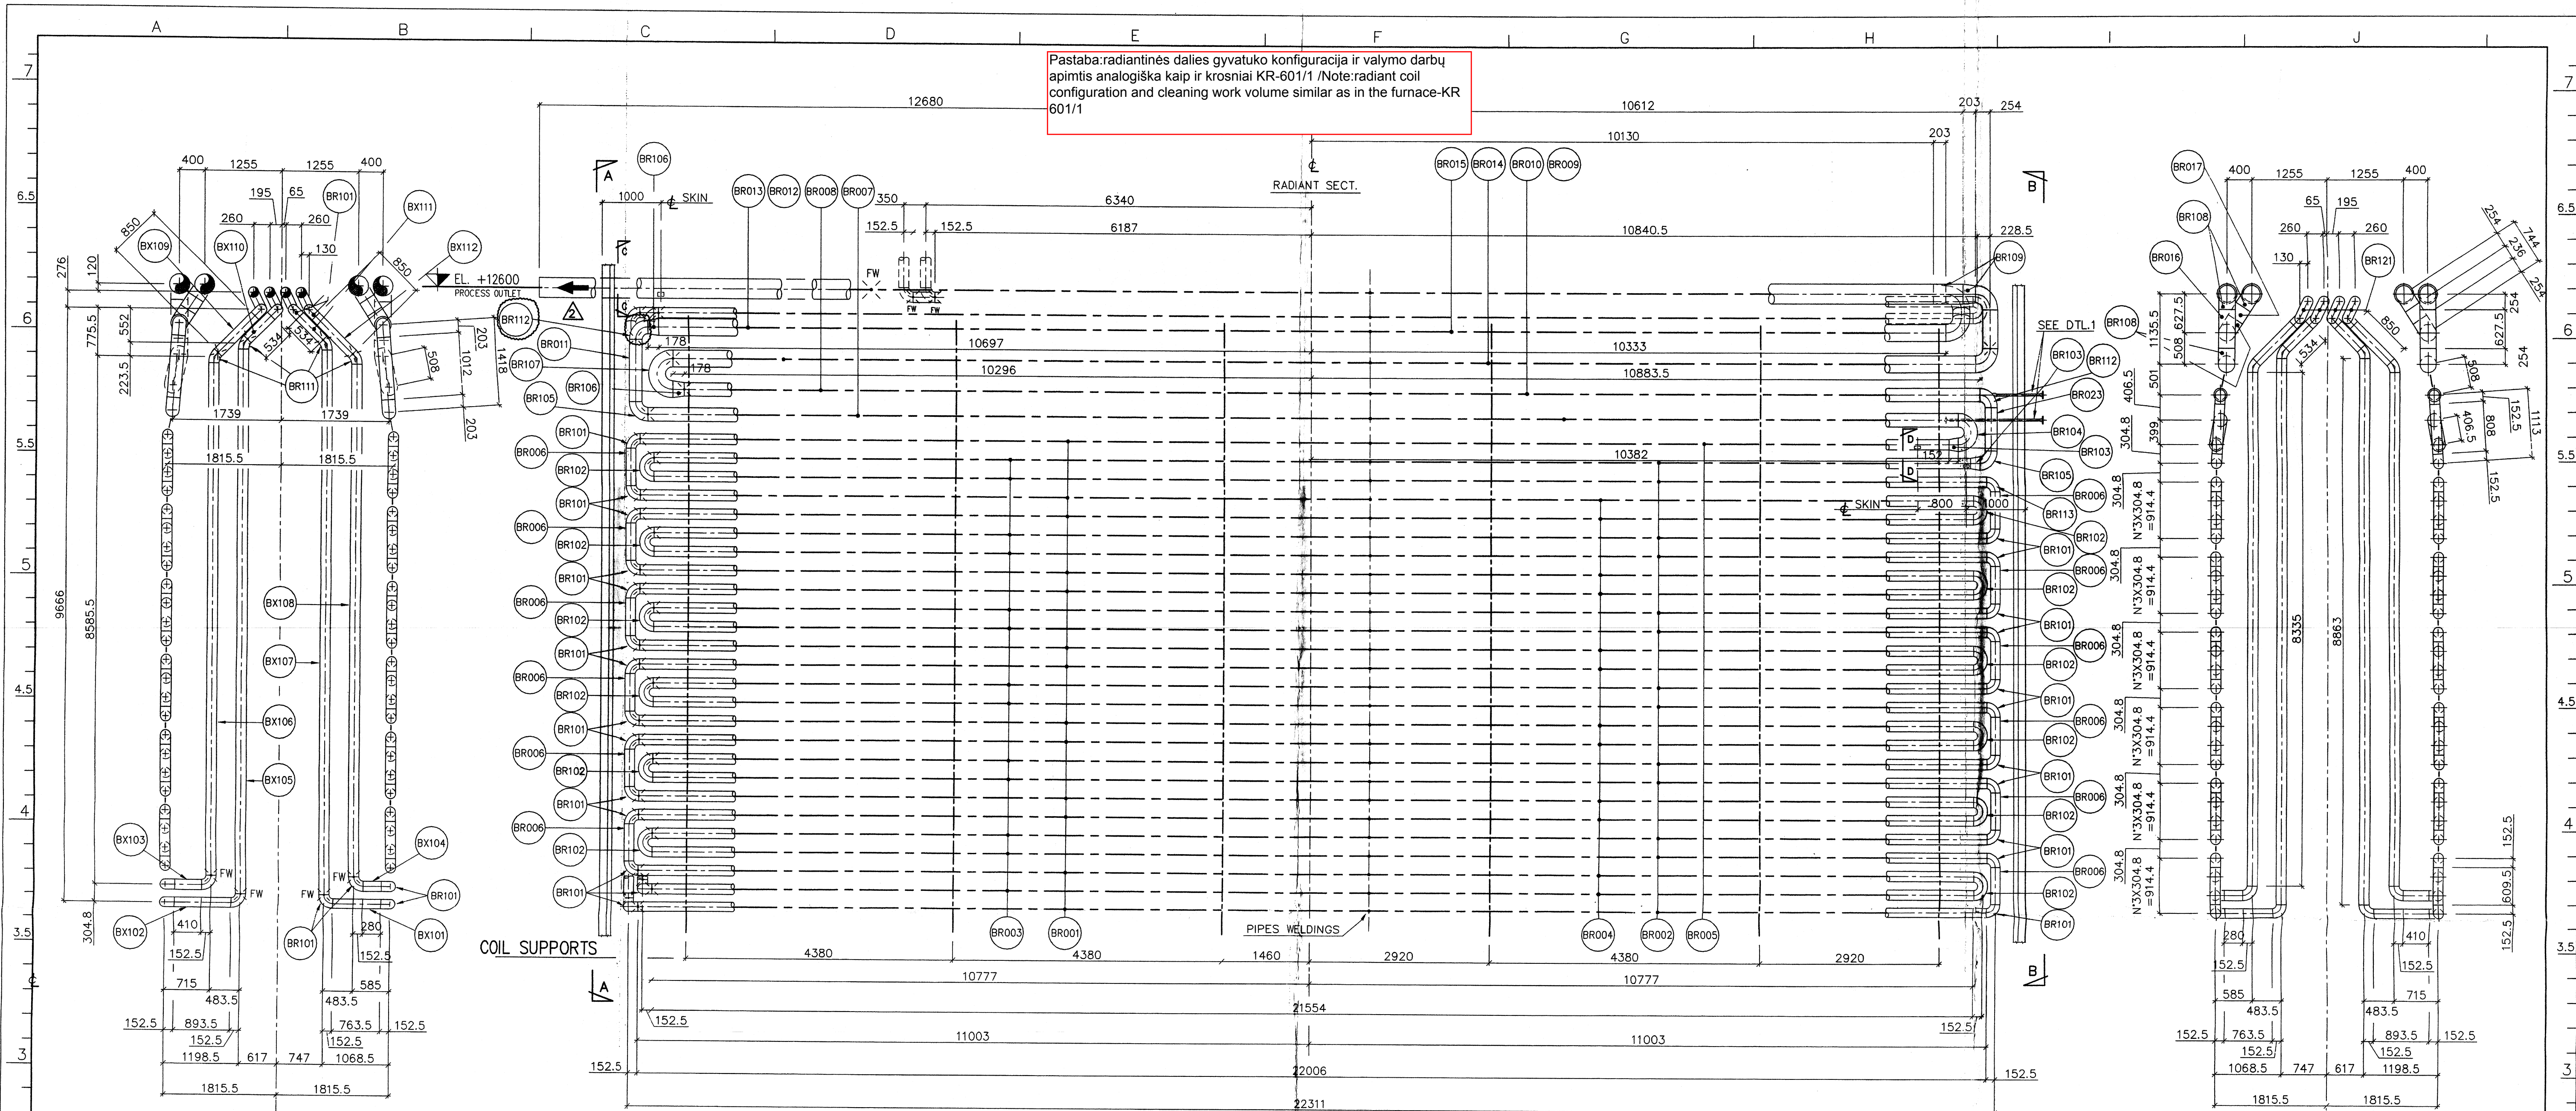

SECTION "A-A"

SECTION "X-X"
LOOKING NORTH

SECTION "B-B"

SECTION "E-E"

SECTION "C-C"

SECTION "D-D"

DETAIL "1"

AS BUILT

Archyvas Nr. 1
20 08.10.10

REFERENCE DRAWINGS	
30589.601.DW.0131.002.01	GENERAL ARRANGEMENT -LONGITUDINAL VIEW
30589.601.DW.0131.002.02	GENERAL ARRANGEMENT -CROSS SECTION
30589.601.DW.0122.001.01	RADIANT COIL KR-601/1
30589.601.DW.0122.001.02	RADIANT COIL SECTION & BILL OF MATERIAL KR-601/1
30589.601.DW.0122.001.04	RADIANT COIL SECTION & BILL OF MATERIAL KR-601/2
30589.601.DW.0127.001.01	CONVECTION COIL & CROSSOVER KR-601/1
30589.601.DW.0127.001.02	CONVECTION COIL & CROSSOVER KR-601/2

NOTES	
2	REVISED AS INDICATED
1	REVISED AS INDICATED
0	FOR CONSTRUCTION
A	FOR APPROVAL

REVISION	DATE	BY	CHKD	APPD
2	18/9/2007	RLE	PCA	F.P.
1	3/9/2007	RLE	PCA	F.P.
0	10/7/2007	D.U.	M.M.	F.P.
A	11/05/2007	D.U.	M.M.	F.P.

MAZEIKIU NAFTA LITHUANIA

AB MAZEIKIU NAFTA MAZEIKIAI, LITHUANIA

Technip KTI

CRUDE OIL PLANT
VACUUM HEATER KR-601/2
RADIANT COIL