




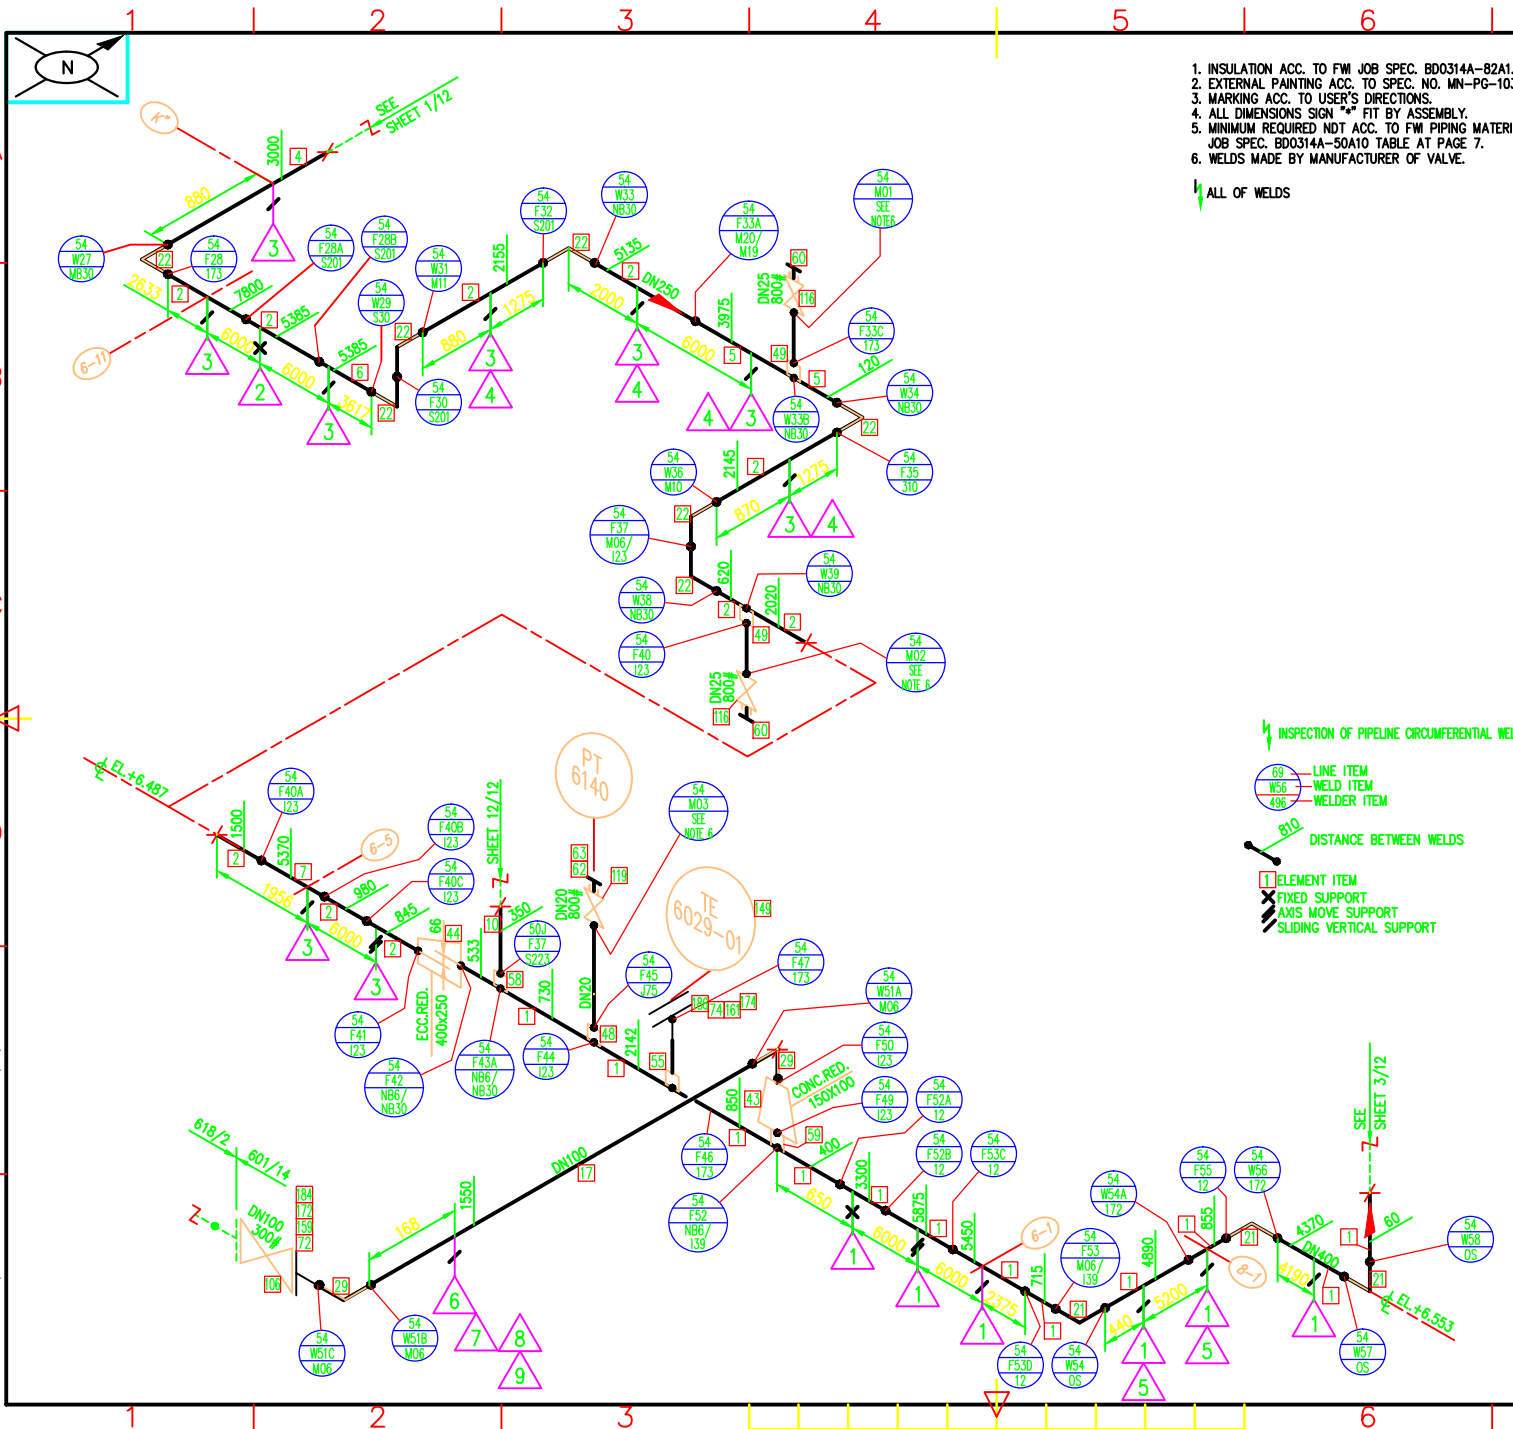

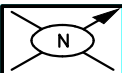

Mechaninių darbų rangovas demontuoja raudona linija pažymėtas vamzdynų atkarpas ir sumontuoja akles su atsakomaisiais flanšais. Plovimo rangovas susimontuoja įrangą plovimo darbams mėlyna strėle pažymėtose vietose /Mechanical contractor dismantles the red line marked pipeline sections and installs the blinds of counter flanges. The washing contractor assembles the equipment for washing work in the areas marked with a blue arrow

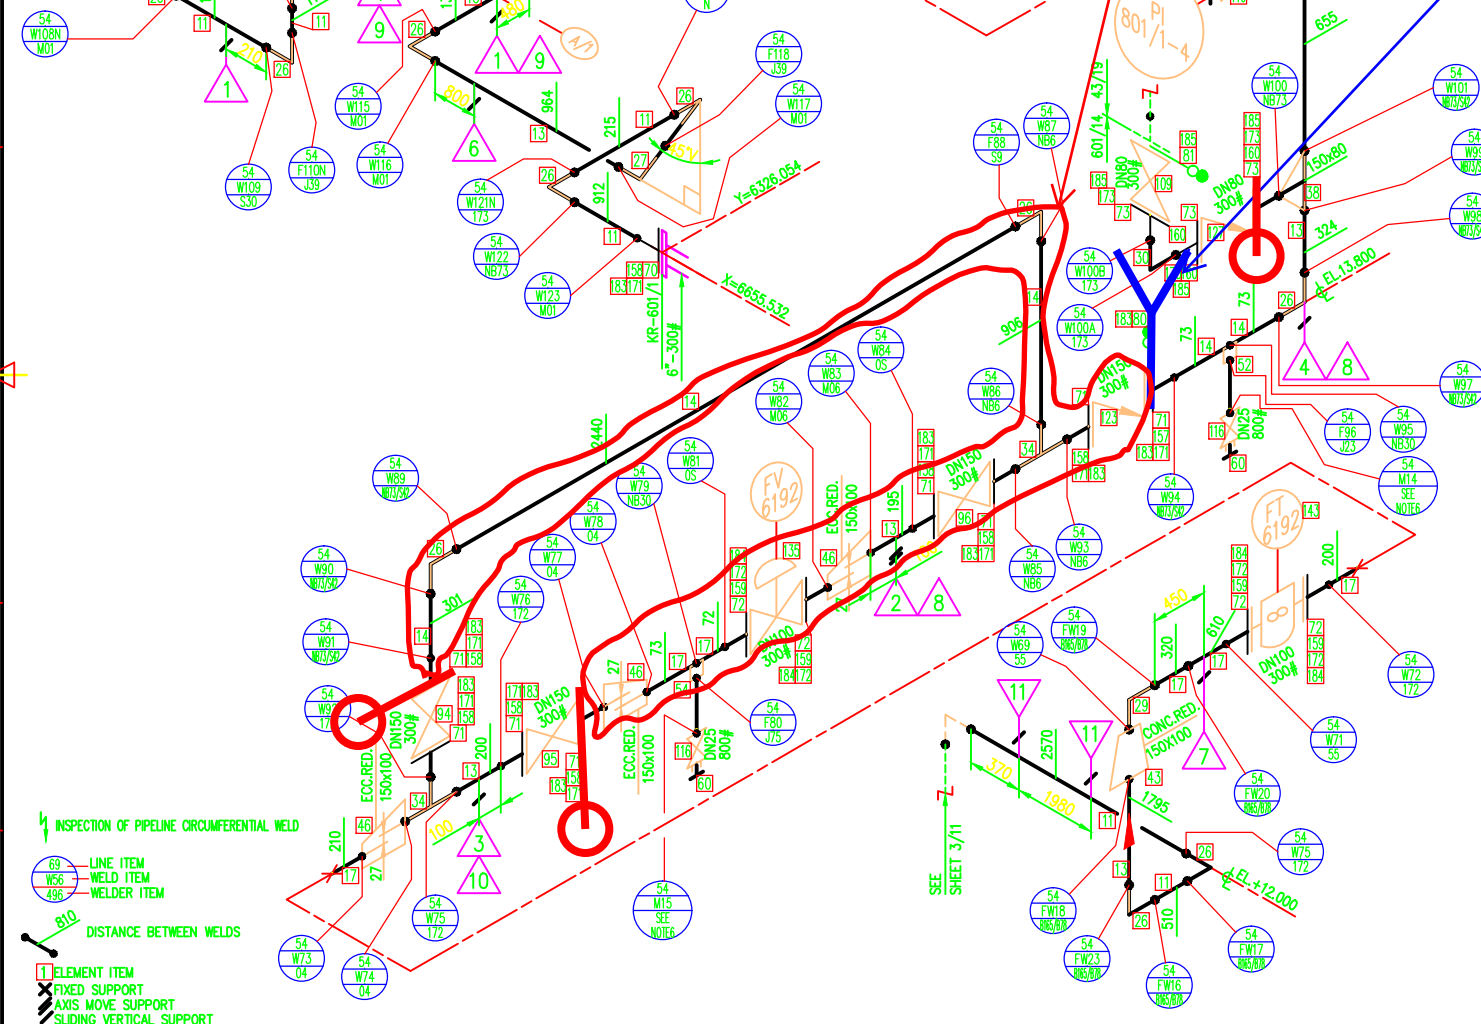

11	100	100.3	FW-030	-	300					2			
10			WS-030	BN						1			
9			WS-030	GN						2			
8			WS-030	GN						2			
7	100	114.3	FW-030	-	300					1			
6	100	100.3	FW-030	-	300					3			
5													
4	100	100.3	FW-030	-	300					1			
3	100	100.3	FW-030	-	300					1			
2	100	100.3	FW-030	-	300					1			
1	100	100.3	FW-030	-	300					1			

No.	BN	GN	Part Description	PIPE	H	V	X	Y	Z	Q-ty	Unit	Location	Remarks
-----	----	----	------------------	------	---	---	---	---	---	------	------	----------	---------

BILL OF MATERIAL

OPER. MEDIUM		TOPPED CRUDE		TEST MEDIUM		WATER	
PARAMETERS	OPER.	DESIGN	TEST	QUALITY LEVEL	VT	RT/UT	MT/PT
PRES. barg	18	23	43	B	100	100	SEE NOTE 5
TEMP. °C	320	365	10+40	PWHT			YES
100	3.5	-	-	-	DN	150	100
150	3.8	-	-	-	TYPE	HC	HC
DN	M.A.W.T.	DN	M.A.W.T.	DN	M.A.W.T.	THK.	100

MINIMUM ALLOWABLE WALL THK.		INSULATION	
HEATING	ST	MATERIAL	P5

CODES	PED, ASME B31.3		
PIPING LAYOUT DWG. NO.	603-10-PJ-015		
P&ID DIAGRAM NO.	GP2-S001/1-10A		
BILL OF MATERIAL NO.	603-50J/54-PR-601/14		

INSPECTION BY	WPT	CLASS ACC.TO PED	1-8
0	AS BUILT. FOR PASSPORT DOC. ONLY		02.2008

REV.	REVISION DESCRIPTION		DATE
0	J. Hoffman	D. Kwiatkowski	K. Jaworski

REV. PREPARED BY	SIGN	CHECKED BY	SIGN	APPROVED BY	SIGN
INVESTOR:	AS MAZEKU NAFTA				


PLANT:	VACUUM UNIT				
PROJECT	VACUUM UNIT REBUILDING				

TITLE:	601/14				
LINE NO.:	601/14				

SIZE	ISO. NO.		SHEET	SHEETS	REV.
A3	603-50J/54-PK-601/14		07	12	00

NAFTOREMONT		PASSPORT DRAWING PREPARED BY			
		Kenczko			

		DESIGN-ENGINEERING FIELD DIVISION			

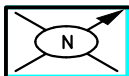

1. INSULATION ACC. TO FW JOB SPEC. BD0314A-82A1.
2. EXTERNAL PAINTING ACC. TO SPEC. NO. MN-PG-1030.
3. MARKING ACC. TO USER'S DIRECTIONS.
4. ALL DIMENSIONS SIGN "4" FIT BY ASSEMBLY.
5. MINIMUM REQUIRED NDT ACC. TO FW PIPING MATERIAL JOB SPEC. BD0314A-50A10 TABLE AT PAGE 7.
6. WELDS MADE BY MANUFACTURER OF VALVE.

ALL OF WELDS

NO.	QTY	DESCRIPTION	UNIT	AMOUNT	DATE	BY	CHKD
1	1	INSULATION	FT	1000	02/2008	J. Hoffman	D. Kwiatkowski
2	1	EXTERNAL PAINTING	FT	1000	02/2008	J. Hoffman	D. Kwiatkowski
3	1	MARKING	FT	1000	02/2008	J. Hoffman	D. Kwiatkowski
4	1	ALL DIMENSIONS	FT	1000	02/2008	J. Hoffman	D. Kwiatkowski
5	1	MINIMUM REQUIRED NDT	FT	1000	02/2008	J. Hoffman	D. Kwiatkowski
6	1	WELDS	FT	1000	02/2008	J. Hoffman	D. Kwiatkowski

BILL OF SUPPLIES

OPER. MEDIUM			TOPPED CRUDE		TEST MEDIUM			WATER		
PARAMETERS		OPER.	DESIGN	TEST	QUALITY LEVEL	VT	RT/UT	MT/PT		
						%			SEE NOTE 5	
PRES. barg		18	23	43	B	100				
TEMP. °C		320	365	10+40	PWHT			YES		
100	3.5	-	-	-	DN	150	100	80	25	
150	3.8	-	-	-	TYPE	HC	HC	HC	HC	
DN	M.A.W.T. DN	M.A.W.T. DN	M.A.W.T. THK.		100	100	100	70		

MINIMUM ALLOWABLE WALL THK. INSULATION

HEATING ST MATERIAL P5 CLASS H2A2

CODES PED, ASME B31.3

PIPING LAYOUT DWG. NO. 603-10-PJ-015

P&ID DIAGRAM NO. GP2-S001/1-10A

BILL OF MATERIAL NO. 603-50J/54-PR-601/14

INSPECTION BY TPT CLASS ACC. TO PED 1-1

0 AS BUILT. FOR PASSPORT DOC. ONLY 02/2008

REV. REVISION DESCRIPTION DATE

0 J. Hoffman D. Kwiatkowski K. Joworski

REV. PREPARED BY SIGN CHECKED BY SIGN APPROVED BY SIGN

INVESTOR: AB MAZEKOW NAFTA

PLANT: VACUUM UNIT

PROJECT: VACUUM UNIT REBUILDING


TITLE: 601/14

SIZE ISO. NO. SHEET SHEETS REV.

A3 603-50J/54-PK-601/14 08 12 00

W20R30-106

Mechaninių darbų rangovas demontuoja raudona linija pažymėtas vamzdynų atkarpas ir sumontuoja akles su atsakomaisiais flanšais. Plovimo rangovas susimontuoja įrangą plovimo darbams mėlyna strėle pažymėtose vietose /Mechanical contractor dismantles the red line marked pipeline sections and installs the blinds of counter flanges. The washing contractor assembles the equipment for washing work in the areas marked with a blue arrow

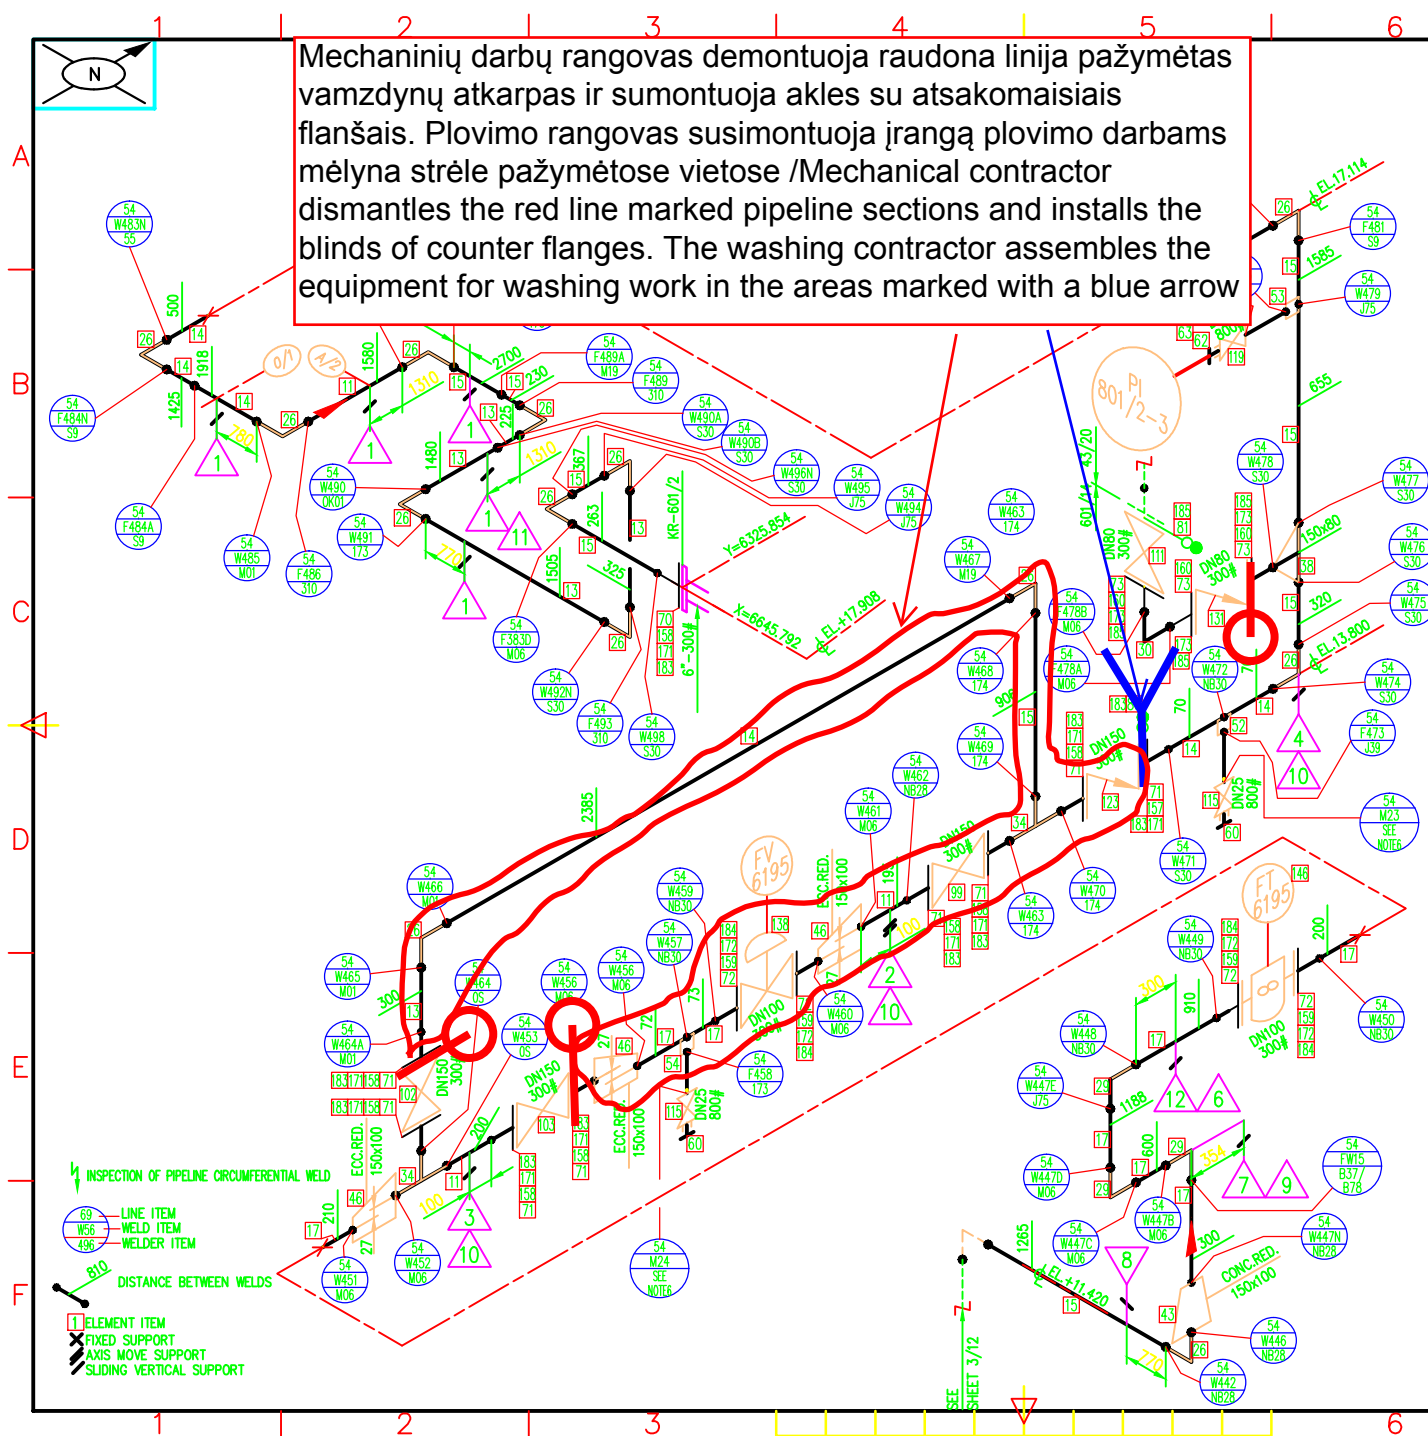

12			K3-019	A		410	180	860		1				
11			K3-012	C4			1540							
10			K3-012	C4			800			3				
9			K3-019			354	220			1				
8	100	100.3	PFB-035	-	860					1				
7	80	80.9	PFB-035	-	100					1				
6	100	114.3	PFB-035	-	120					1				
5			(REMOVED)							1				
4	100	100.3	PFB-035	-	310					1				
3	100	100.3	PFB-032	-	310					1				
2	100	100.3	PFB-032	-	310					1				
1	100	100.3	PFB-035	-	130					8				
No.	DN	O.D.	Part Description	TYPE	H	V	X	Y	Z	G-by plates/instruments	Unit	Tolerance		
BILL OF SUPPLIES														
OPER. MEDIUM			TOPPED CRUDE			TEST MEDIUM			WATER					
PARAMETERS		OPER.		DESIGN		TEST		QUALITY LEVEL		VT	RT/UT	WT/PT		
PRES. barg		18		23		43		B		100	100	%	SEE NOTE 5	
TEMP. °C		320		365		10+40				PWHT		YES		
100	3.5	-	-	-	-	DN		150	100	80	25			
150	3.8	-	-	-	-	TYPE		HC	HC	HC	HC			
DN	M.A.W.T.	DN	M.A.W.T.	DN	M.A.W.T.	THK.		100	100	100	70			
MINIMUM ALLOWABLE WALL THK.								INSULATION						
HEATING		ST		MATERIAL		P5		CLASS		H2A2				
CODES		PED, ASME B31.3												
PIPING LAYOUT DWG. NO.				603-10-PJ-015										
P&I DIAGRAM NO.				GP2-S001/1-10A										
BILL OF MATERIAL NO.				603-50J/54-PR-601/14										
INSPECTION BY			TPT			CLASS ACC.TO PED			1-H					
0	AS BUILT. FOR PASSPORT DOC. ONLY											02.2008		
REV.	REVISION DESCRIPTION											DATE		
0	J. Hoffman			D. Kwiatkowski			K. Jaworski							
REV.	PREPARED BY	SIGN	CHECKED BY	SIGN	APPROVED BY	SIGN								
INVESTOR:		AD MAZENKU NAFTA												
PLANIT:		VACUUM UNIT												
PROJECT TITLE:		VACUUM UNIT REBUILDING												
LINE NO.: 601/14														
 NAFTOREMONT DESIGN-ENGINEERING FIELD DIVISION														
SIZE		ISO. NO.						SHEET		SHEETS		REV.		
A3		603-50J/54-PK-601/14						10		12		00		

